


GROUND FLOOR

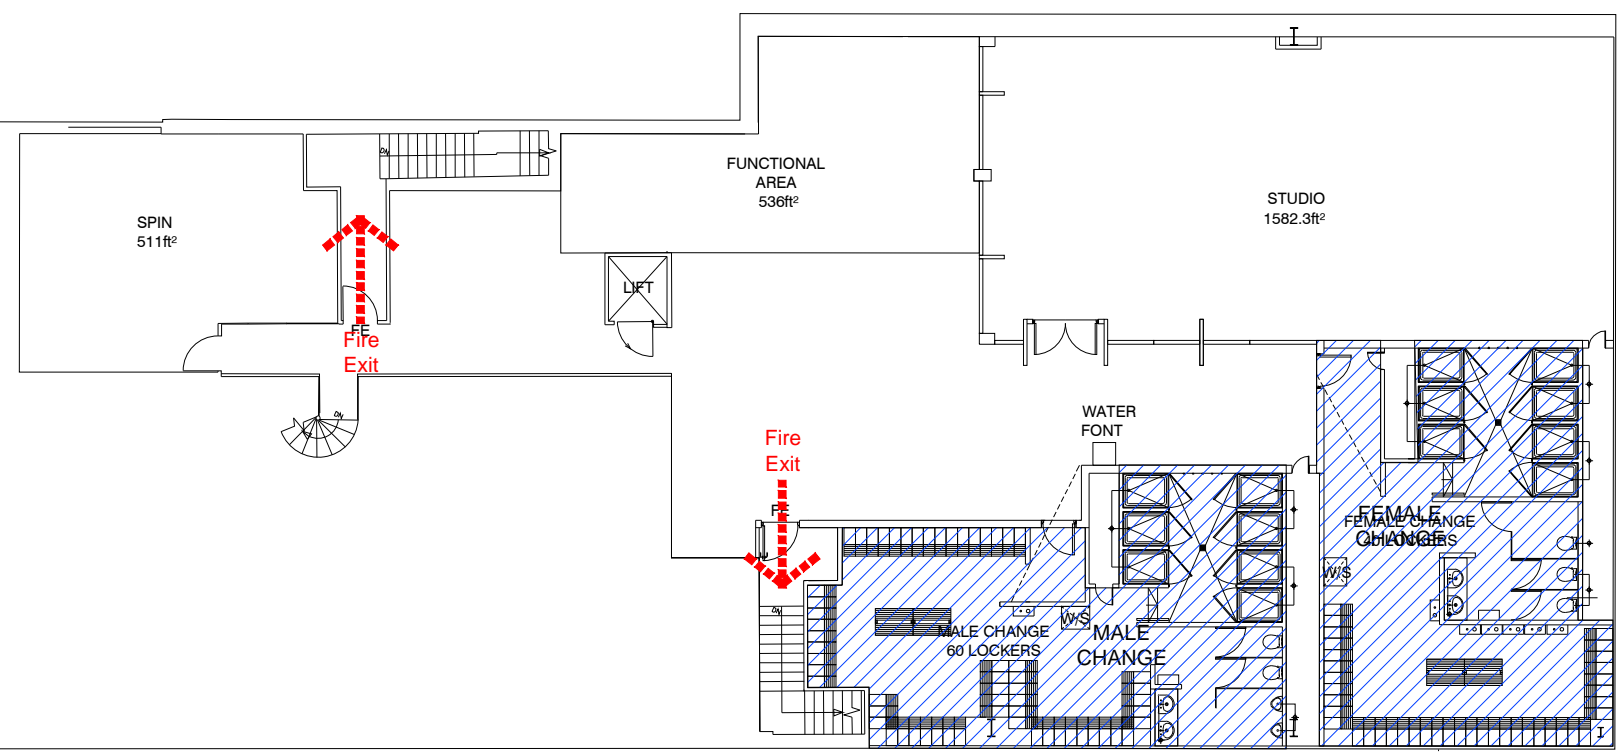

FIRST FLOOR

- B 11.01.17 Plan updated to reflect as-built scenario GL HM
- A 01.11.16 Plant room and server room upstairs removed; Plant room downstairs enlarged; Functional Area added; Lobby area re-configured to accommodate Pods; Vending Area reduced; Room areas added GL HM

CLIENT Pure Gym Ltd			
PROJECT TITLE Sefton Street, Liverpool			
DRAWING TITLE Fire Evacuation Plan Ground and First Floor			
DRAWING PURPOSE FOR CONSTRUCTION			
DRAWN / CHECKED CM/GL	DATE JUN '16	SCALE 1:200@ A3	
JOB No 1PG144	DRAWING No 2-600	STATUS --	REVISION B
51 Barton Arcade T +44 (0)161 834 1018			
Deansgate F +44 (0)161 834 4798			
Manchester E contact@mhaarchitects.com			
M3 2BJ W www.mhaarchitects.com			